
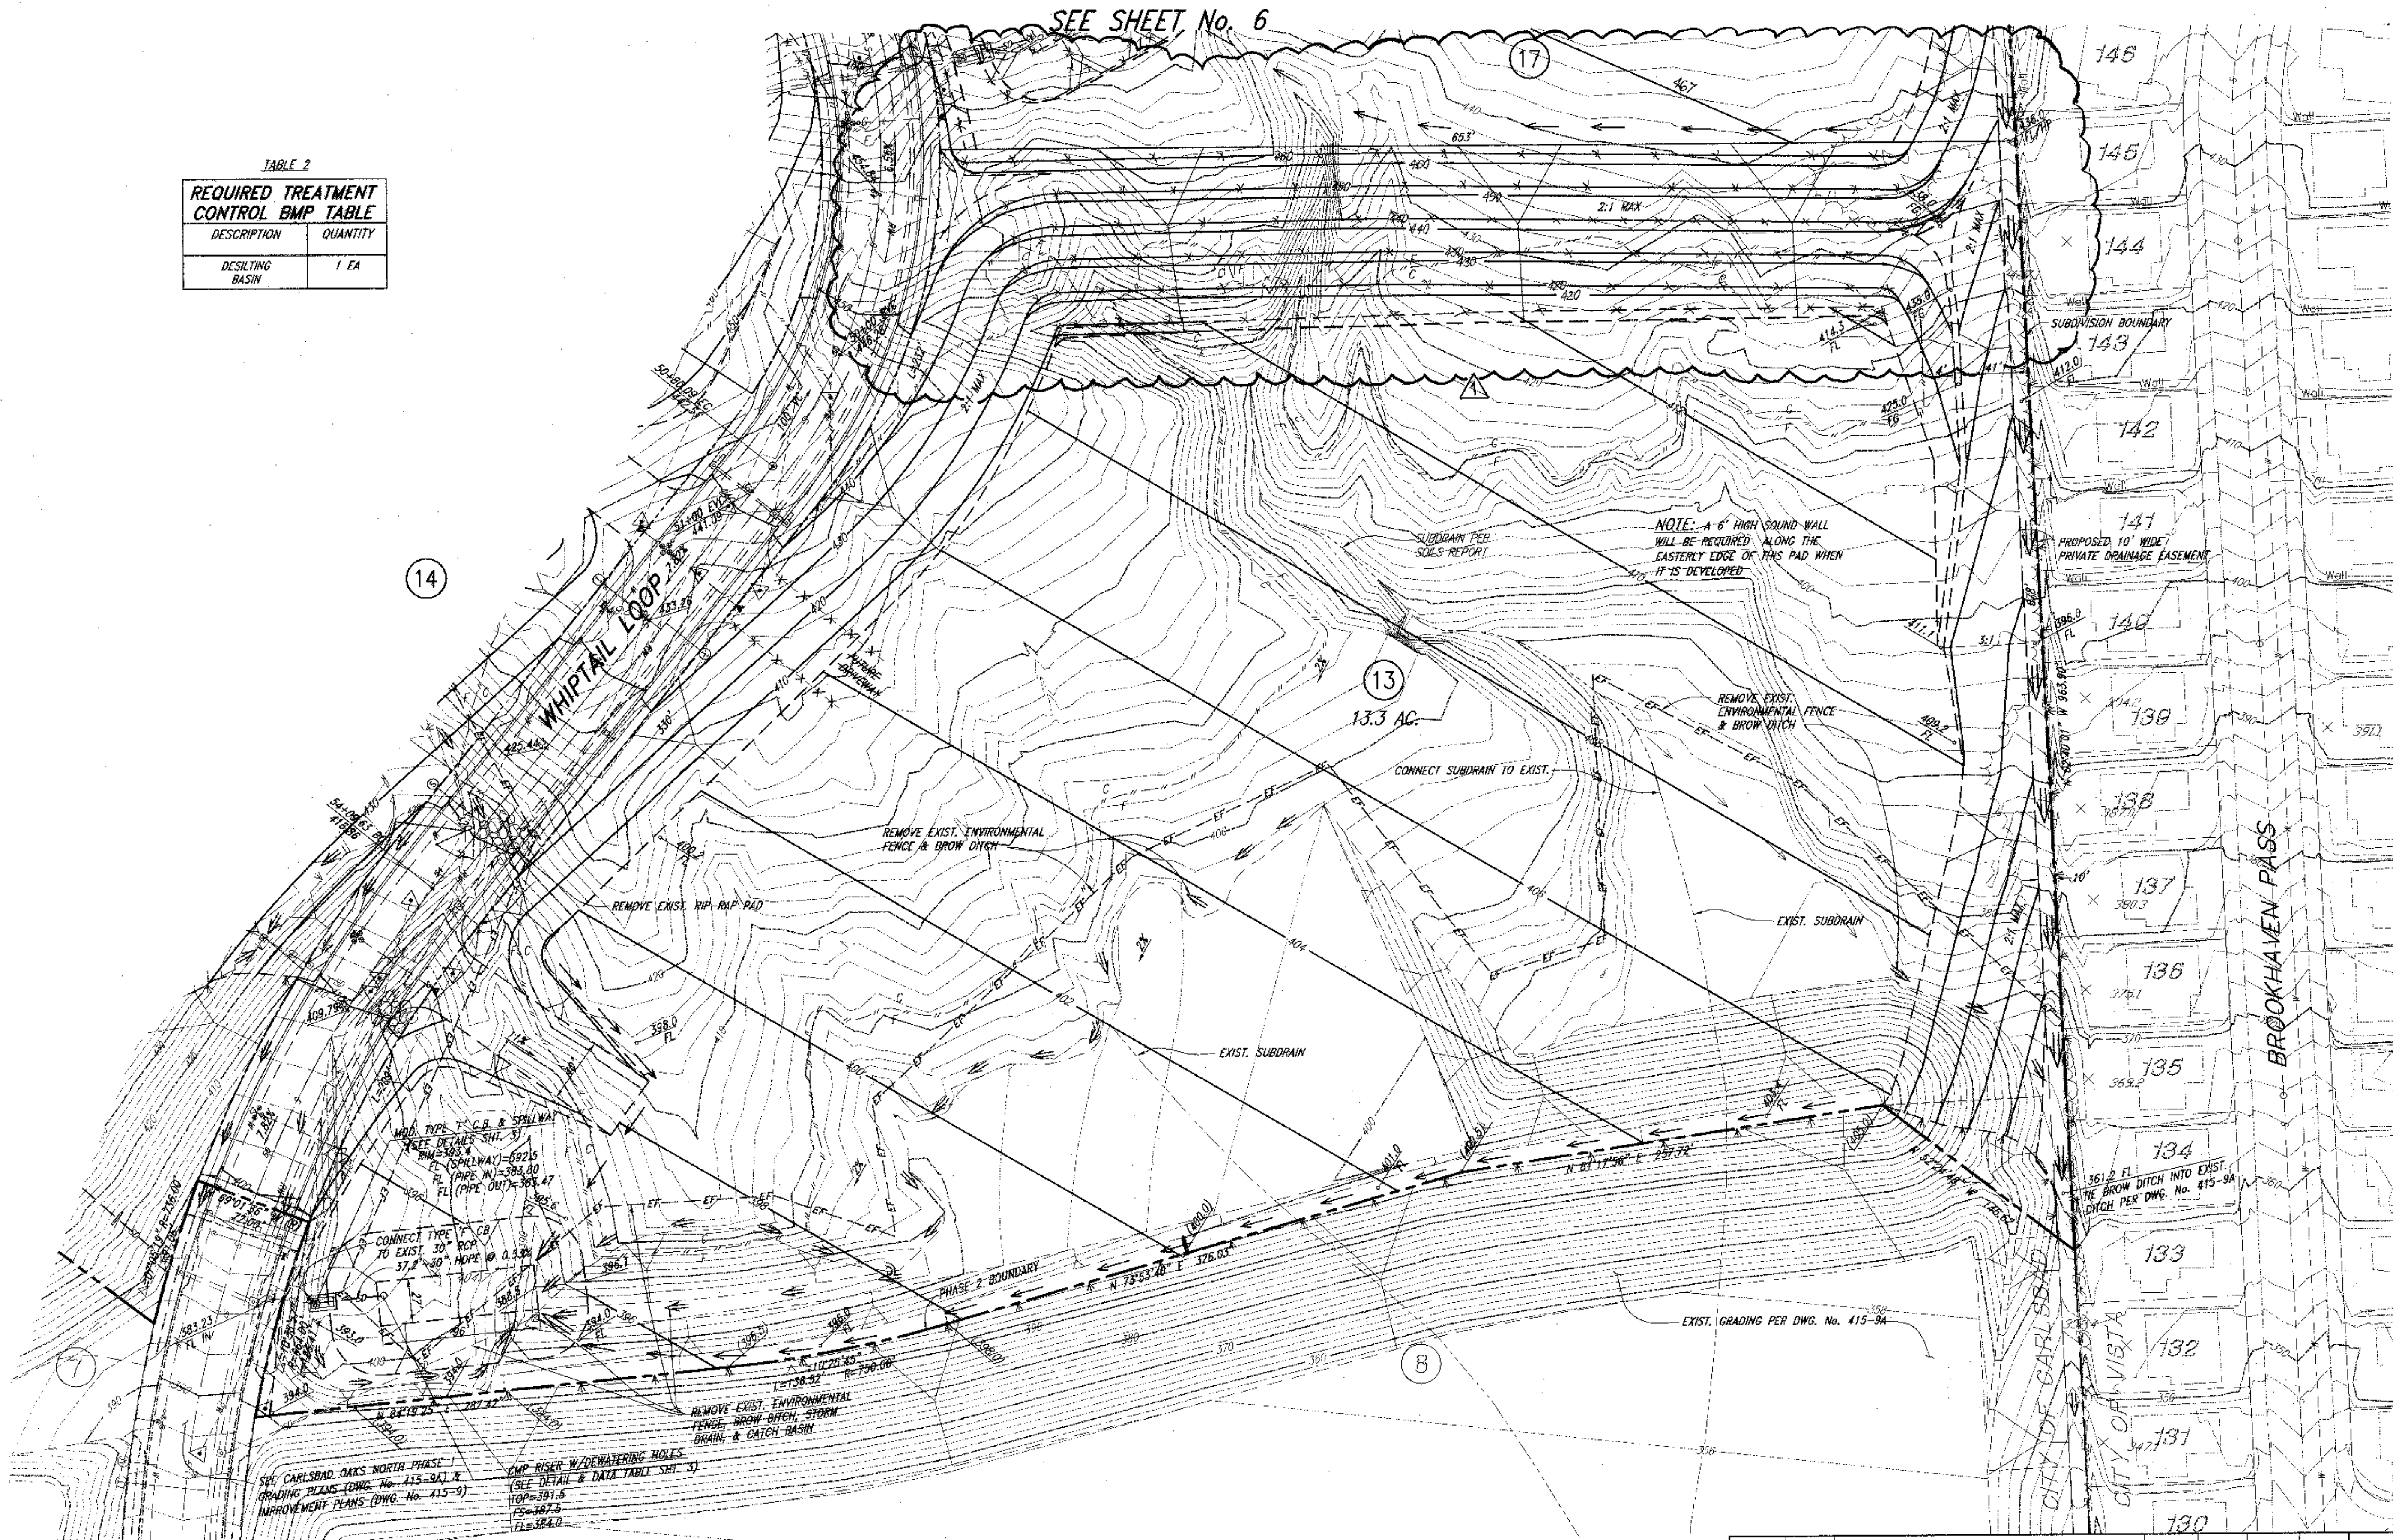


SEE SHEET No. 4

SEE SHEET No. 6

TABLE 2
REQUIRED TREATMENT CONTROL BMP TABLE

DESCRIPTION	QUANTITY
DESILTING BASIN	1 EA

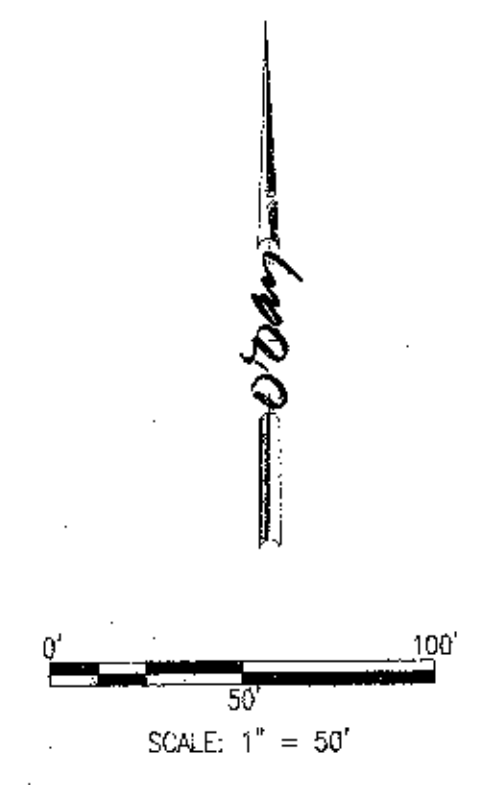

NOTE!!
ELECTRONIC DATA FILES ARE FOR REFERENCE ONLY AND ARE NOT TO BE USED FOR HORIZONTAL OR VERTICAL SURVEY CONTROL



O'Day CONSULTANTS
2710 Laker Avenue West, Suite 100
Carlsbad, California 92010
760-931-7100
Fax: 760-931-8680
www.odayconsultants.com

Civil Engineering
Planning
Processing
Surveying

DESIGNED BY: A.V. H.R. DATE: FEBRUARY 2006
DRAWN BY: I.G., G.M. SCALE: 1" = 50'
PROJECT MGR.: T.O.C. JOB NO.: 96-1005

ENGINEER OF WORK:
Timothy D. Carroll, Jr.
TIMOTHY D. CARROLL, JR. DATE: 8/16/06 RCE: 55381

"AS BUILT"
Timothy D. Carroll, Jr. 8/3/09
TIMOTHY D. CARROLL, JR. P.E. 55381 EXP. 12/31/10 DATE

REVIEWED BY:
Monty A. Clark 9/23/09
INSPECTOR DATE

BENCHMARK:
DESCRIPTION: 2" ALUMINUM DISC STAMPED GPS CONTROL PT. 2002
LOCATION: IN SIDEWALK NORTH SIDE OF PALOMAR AIRPORT ROAD, 300 FEET WEST OF MELROSE DRIVE
RECORD FROM: R.C.S. NO. 17271 (PT. NO. 71)
ELEVATION: 444.00 M.S.L. DATUM: NGVD 1929

DATE	INITIAL	REVISION DESCRIPTION	DATE	INITIAL	OTHER APPROVAL	DATE	INITIAL	CITY APPROVAL
2/10/09	TC	AS-BUILT	8/3/09	CW				
1/22/07	TC	REVISED GRADING						

SHEET 5	CITY OF CARLSBAD ENGINEERING DEPARTMENT	SHEETS 9
GRADING PLANS FOR: CARLSBAD OAKS NORTH PHASE 2		
APPROVED BY: <i>Conrad C. Hammann, Jr.</i> 11/29/08 PE 53069 EXP: 06/30/08 CITY ENGINEER DATE		
DOWN BY: GVP	PROJECT NO. C.T. 97-13	DRAWING NO. 415-9I

I:\961005\Shim\Phase 2\081101\CP4.mxd, Map\96056035.dwg, Oct 31, 2006 1:18pm
xrefs: 960560; 960560MAP; 960560P13; 960560A11; 960560J11; 960560K11; 960560L11; 960560M11; 960560N11; 960560O11; 960560P11; 960560Q11; 960560R11; 960560S11; 960560T11; 960560U11; 960560V11; 960560W11; 960560X11; 960560Y11; 960560Z11